

STURTS VARD

DESIGN AND ACCESS STATEMENT ADDENDUM 3

STUDIO EGRET WEST ON BEHALF OF ACCESS SELF STORAGE STURT'S YARD, 48 EAGLE WHARF ROAD, HACKNEY, PLANNING APPLICATION

REV	DATE	DESCRIPTION	BY	CHECK
P0	21.07.08	PLANNING SUBMISSION	JT	AP
P1	21.07.21	PLANNING SUBMISSION	JT	AP
	:	i de la constante de	i	

2 ~~~~

CLIENT ~~ Access Self Storage PLANNER ~~ DP9 COMMUNITY CONSULTATION ~~ Polity POLITICAL CONSULTATION \sim Polity ARCHITECT ~~ Studio Egret West LANDSCAPE ARCHITECT ~~ Studio Egret West CIVIL ENGINEER ~~ Alan Baxter & Associates STRUCTURAL ENGINEER ~~ Alan Baxter & Associates SERVICES ENGINEER $\sim\sim$ Foreman Roberts ENERGY ENGINEER ~~ Foreman Roberts HERITAGE CONSULTANT ~~ Alan Baxter & Associates TRANSPORT ENGINEER ~~ Alan Baxter & Associates ACOUSTIC ENGINEER $\sim\sim$ SRL Technical Services ACCESS CONSULTANT $\sim \sim$ Buro Happold TOWNSCAPE ~ Peter Stewart Consultancy ECOLOGIST/ARBORIST ~~ PJC Consultancy BREEAM ~~ Foreman Roberts PRINCIPAL DESIGNER ~ Potter Raper Partnership DAYLIGHT/SUNLIGHT ~~ EB7 ROL ~~ EB7 FIRE ENGINEER ~ Bureau Veritas APPROVED INSPECTOR ~~ Bureau Veritas QUANTITY SURVEYOR ~~ Cast VIABILITY CONSULTANT \sim DS2 WASTE CONSULTANT $\sim\sim$ Waterman Infrastructure & Environment Ltd AGENT ~~ Currell VERIFIED VIEWS ~~ Cityscape CONSULTING CONTRACTOR $\sim\sim$ McLaren Group

STUDIO EGRET WEST

6 1.0 ~ DESIGN EVOLUTION: RESPONSE TO LONDON BOROUGH OF HACKNEY FEEDBACK JUNE 2021


- 7 1.1 LAYOUT: COURTYARD BALCONIES
- 8 1.2 LAYOUT: AFFORDABLE WORKSPACE PROVISION
- 9 1.3 LAYOUT: AFFORDABLE HOUSING PROVISION
- 10 1.4 MATERIALITY AND DETAILING: 1.8M HIGH FROSTED GLASS PARTITIONS TO INTERNAL COURTYARD BALCONIES
- 11 1.5 MATERIALITY AND DETAILING: LIGHT-WELL TO BASEMENT OFFICE SPACE
- 12 1.6 LANDSCAPE: DEFENSIBLE SPACE
- 13 1.7 LANDSCAPE: CANAL EDGE
- 14 1.8 ASPECT: ORIENTATION OF HOMES
- 16 2.0 \sim APPENDICES

4 ~~~~

N0.48 EAGLE WHARF \sim DESIGN AND ACCESS STATEMENT

STUDIO EGRET WEST

1.0 __DESIGN EVOLUTION: RESPONSE TO LONDON BOROUGH OF HACKNEY FEEDBACK JUNE 2021

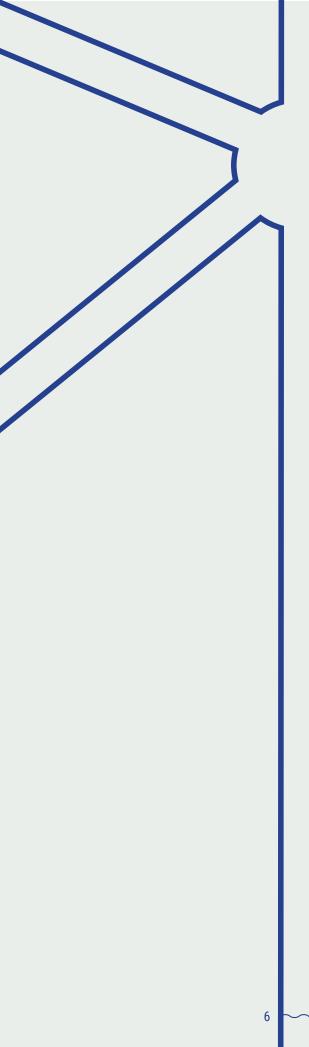

LAYOUT COURTYARD BALCONIES

LBH DESIGN COMMENTS (24/06/21) :

Repositioning/ privacy screening/ part recessing of the balconies within the internal faces of the blocks, so that they do not directly neighbour other balconies/ windows.


Ideally balconies should be placed off living rooms and staggered to reduce the loss of daylight to those rooms. Alterations to the unit layouts to enable such changes would be welcomed.

Revised figures for the internal daylighting/ sunlight of rooms should be provided.

SEW RESPONSE:

Balcony positions within courtyards have been explored by SEW and EB7. The exercise concluded that the balconies could be staggered further apart without impacting further on the daylight/sunlight levels into units with balconies and windows. In addition to the repositioning of balconies an integrated 1800mm high frosted glazing panels have been added to the side of balconies in four locations which are in close proximity to neighbouring windows.

Recessed balconies within the courtyard have been investigated by SEW previously. Inset balconies were seen to be detrimental given their impact on the quality of layout design, daylight/ sunlight within internal living spaces and their impression on the form and composition of central blocks. Inset balconies have been included on the south facing home within the courtyard of the western block where internal daylight/sunlight levels are sufficient.

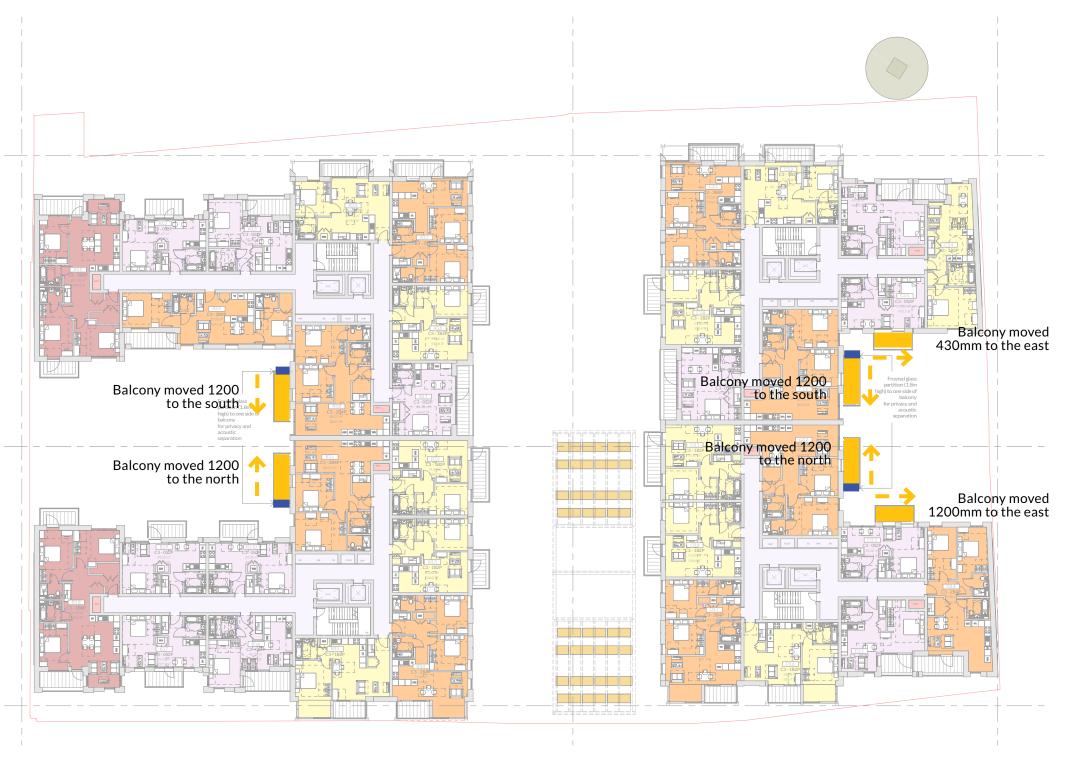

Level 03 (typical upper) floor plan

Key

STUDIO EGRET WEST

Position of amended balcony

Location of 1.8m high frosted glazed partitions


LAYOUT AFFORDABLE WORKSPACE PROVISION

LBH DESIGN COMMENTS (06/07/21) :

Clarification of affordable workspace location required. LBH will not accept affordable workspace in the basement.

SEW RESPONSE:

All office space at Level 00 and Level 01 is designated as potential affordable workspace at this stage with the location to be reviewed at a later stage.

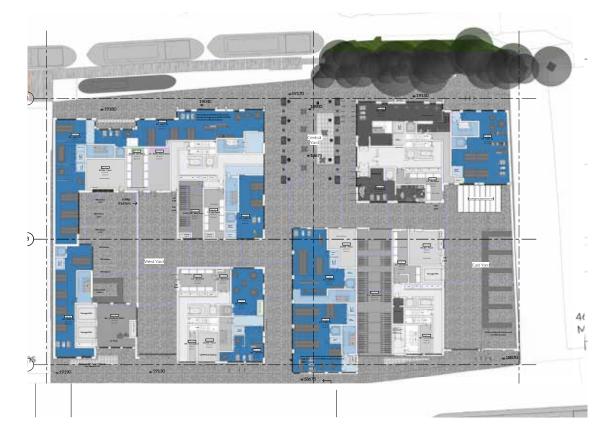

Level 00 - GA plan



Level 01 - GA plan



Office space/potential affordable workspace

Office space/potential affordable workspace

LAYOUT AFFORDABLE HOUSING PROVISION

LBH DESIGN COMMENTS (07/07/21) :

Clarification of affordable housing location required.

SEW RESPONSE:

The location of affordable homes is highlighted on the adjacent plans.

Affordable Homes Provision:

14 units split between: 10 x 1 Beds (Hackney Living Rent) 4 x 2 Beds (Hackney Living Rent)



STUDIO EGRET WEST

MATERIALITY AND DETAILING 1.8M HIGH FROSTED GLASS PARTITIONS TO INTERNAL COURTYARD BALCONIES

LBH DESIGN COMMENTS (02/07/21) :

Further clarification of position and detailing of internal courtyard screens.

SEW RESPONSE:

SEW have updated planning drawings to note the location of balconies with frosted glass partitions in GA plans.

The design intent is for the frosted glazed panels is to provide suitable privacy without impinging on daylight to corner windows. Panels will be integrated into the balcony design with aluminium framing to match the colour and proportions of balcony railings and balustrades.

Drawings 0276-SEW-PA-ZZ-DR-A-001308 and 0276-SEW-PA-ZZ-DR-A-001310 have been updated to describe call-out and assembly details for 1.8m high umber aluminium frames and frosted glazed screens as noted on the relevant drawings and material legend.



Precedent images: Frosted glass balcony partition with aluminium frame



Internal courtyard balconies: Frosted glass partition assembly

MATERIALITY AND DETAILING LIGHT-WELL TO BASEMENT OFFICE SPACE

LBH DESIGN COMMENTS (24/06/21) :

Provision of light-wells (rather than a roof light) for the basement office floorspace.

SEW RESPONSE:

SEW have confirmed that this is not possible owing to the vehicle tracking into courtyard space. Additional glass-bricks can be provided over the space to allow natural light into the space but would be limited. Glass-bricks in this area could be reserved as a condition.



Precedent image of glass-brick system



Level B1 - GA Plan

-19150

1997



Level 00 - GA Plan with tracking overlay

LANDSCAPE **DEFENSIBLE SPACE**

LBH DESIGN COMMENTS (24/06/21) :

Is the provision of defensible space in front of the second floor residential windows overlooking species. the second floor amenity spaces adequate?

Please also provide details of what this does to Shaping Neighbourhoods: Play and Informal the overall provision of communal amenity/play space.

SEW RESPONSE:

SEW believe that defensible planting is the most appropriate means to provide privacy to homes which are adjacent to communal terraces whilst simultaneously creating an attractive verdant space for people to sit, relax and eat. This approach will ensure that both private and shared terraces feel embedded in planting. The character and use of different outdoor areas will be defined by different planting types with varying densities. Defensible boundary planting is a common strategy used to help alleviate overlooking and noise concerns.

In the majority of cases, private outdoor amenity spaces in front of apartment windows maintain a minimum width of 2m to provide privacy and separation for residents living adjacent to shared outdoor amenity terraces. On the eastern edge of the social terrace planted boundaries have been increased in width to ensure 2m is retained in all instances. A mixture of structural and herbaceous plant species have been specified within the planting palate to ensure that robust species can be used adjacent to windows. In the central social terrace a raised truss frame is populated with climbing plants which will provide an additional level of screening between flat windows and amenity spaces.

As illustrated on p196 of the September 2018 Design and Access statement planting is included within the play area calculation.

Sensory planting is considered part of the play strategy for younger children. As a result, the planting mix within the play space includes ornamental grasses and colourful herbaceous

As stated in supplementary planning guidance Recreation planting should be integrated into play spaces where feasible.



Level 02 social terrace - GA plan



Precedent images for different character areas within Level 02 social terrace

1. Eating space

2. Play area

3. Large numbers sun deck

4. Main access between buildings

5. Boundary planting

6. Pergola

7. Perimeter wall

Width of defensible planting increased from 1.5m to 2m



LANDSCAPE **CANAL EDGE**

LBH DESIGN COMMENTS (19/07/21) :

The committee would benefit from details of the edge condition where the site meets the weir. Are we agreed that planters in these areas are to form a barrier in the same way a fence or wall would?

SEW RESPONSE:

The boundary between pedestrian path and lock wall will incorporate metal edged planters with integrated seating within the application boundary. The metalwork would be in a colour to match the tone of metalwork used across the building.

Planters will incorporate herbaceous native mixed hedge rows of circa 1.1m height to create an impermeable barrier between the pedestrian path within the application Site and the weir.







Precedent images of herbaceous native mixed hedge rows within metal edged planters



STUDIO EGRET WEST

Location of herbaceous native mixed hedge rows within metal edged planters within application boundary.

ASPECT **ORIENTATION OF HOMES**

LBH DESIGN COMMENTS (24/06/21) :

Officers have asked for the number/proportion of single aspect units, along with their orientation.

SEW RESPONSE:

There are 69 (50%) single aspect homes in the scheme of which 16 (12%) are single aspect north facing. Details of single, corner and dual aspect homes are shown in the adjacent table and diagrams.

Please note that corner aspect homes are considered to be dual aspect.

Floor By Floor Aspect Design Change

- Single Aspect
- Corner Aspect
- Dual Aspect

Level 02

Level 03

Level 04







Details of the amount of single, corner and dual aspect homes

Single Aspect Homes (Northwest Facing)	Single Aspect Homes (East, South, West)	Corner Aspect Homes	Dual Aspect Homes	Total Homes Per Floor
4	14	7	10	34
4	14	7	10	34
4	14	7	10	34
4	11	4	9	28
0	0	0	6	6
16	53	25	45	139
12%	38%	18%	32%	100%
		50%		


Level 05

Level 06

Commercial Cafe

STUDIO EGRET WEST

$2.0\ {}_{\sim}\ APPENDICES$

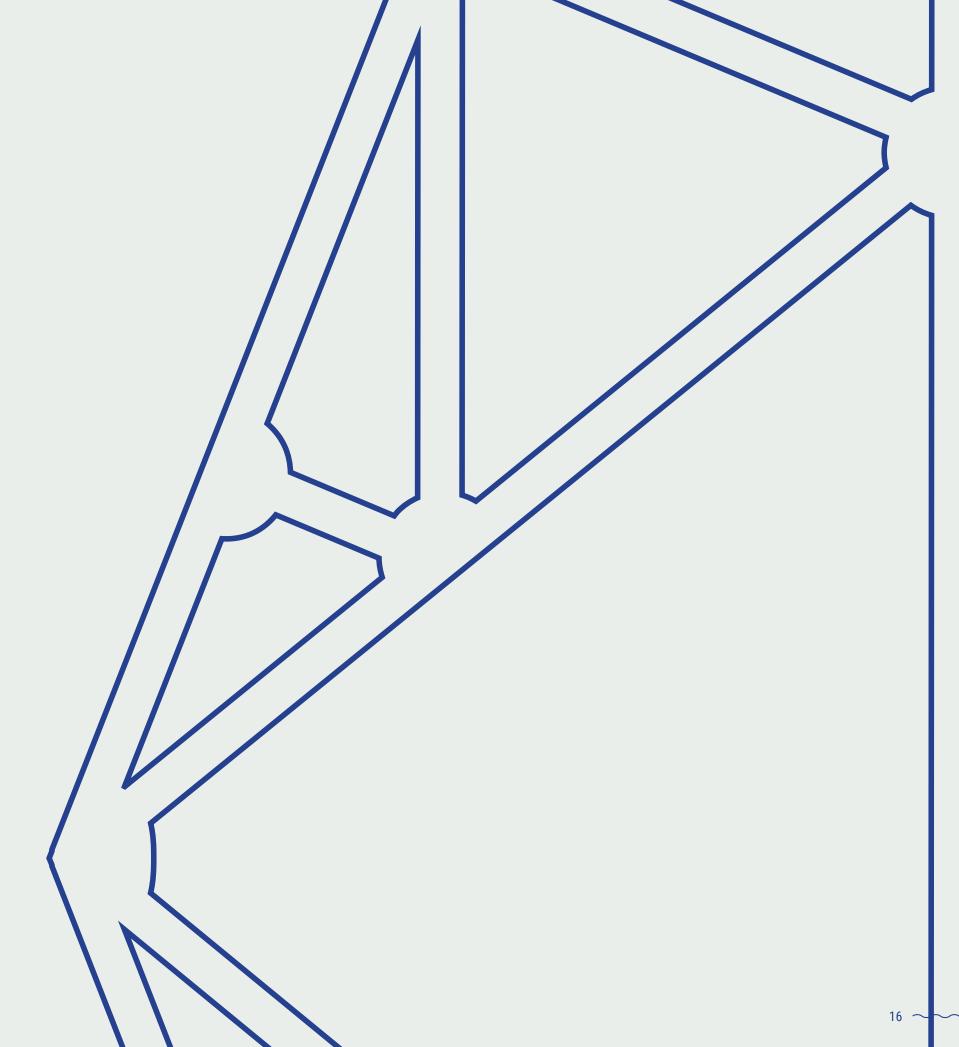


Floor Plans

-Colour coded to illustrate use allocation and residential mix. A1 scale general arrangement plans are submitted separately as part of the application.

Proposed Access Site - GA Plan - Level 00 Proposed Access Site - GA Plan - Level 01 Proposed Access Site - GA Plan - Level 02 Proposed Access Site - GA Plan - Level 03 Proposed Access Site - GA Plan - Level 04 Proposed Access Site - GA Plan - Level 05 Proposed Access Site - GA Plan - Level 06 Proposed Access Site - GA Plan - Roof Level

0276-SEW - PA-00-DR - A-001100 0276-SEW - PA-00-DR - A-001101 0276-SEW - PA-02-DR - A-001102 0276-SEW - PA-03-DR - A-001103 0276-SEW - PA-04-DR - A-001104 0276-SEW - PA-05-DR - A-001105 0276-SEW - PA-05-DR - A-001106 0276-SEW - PA-10-DR - A-001110


STUDIO EGRET WEST

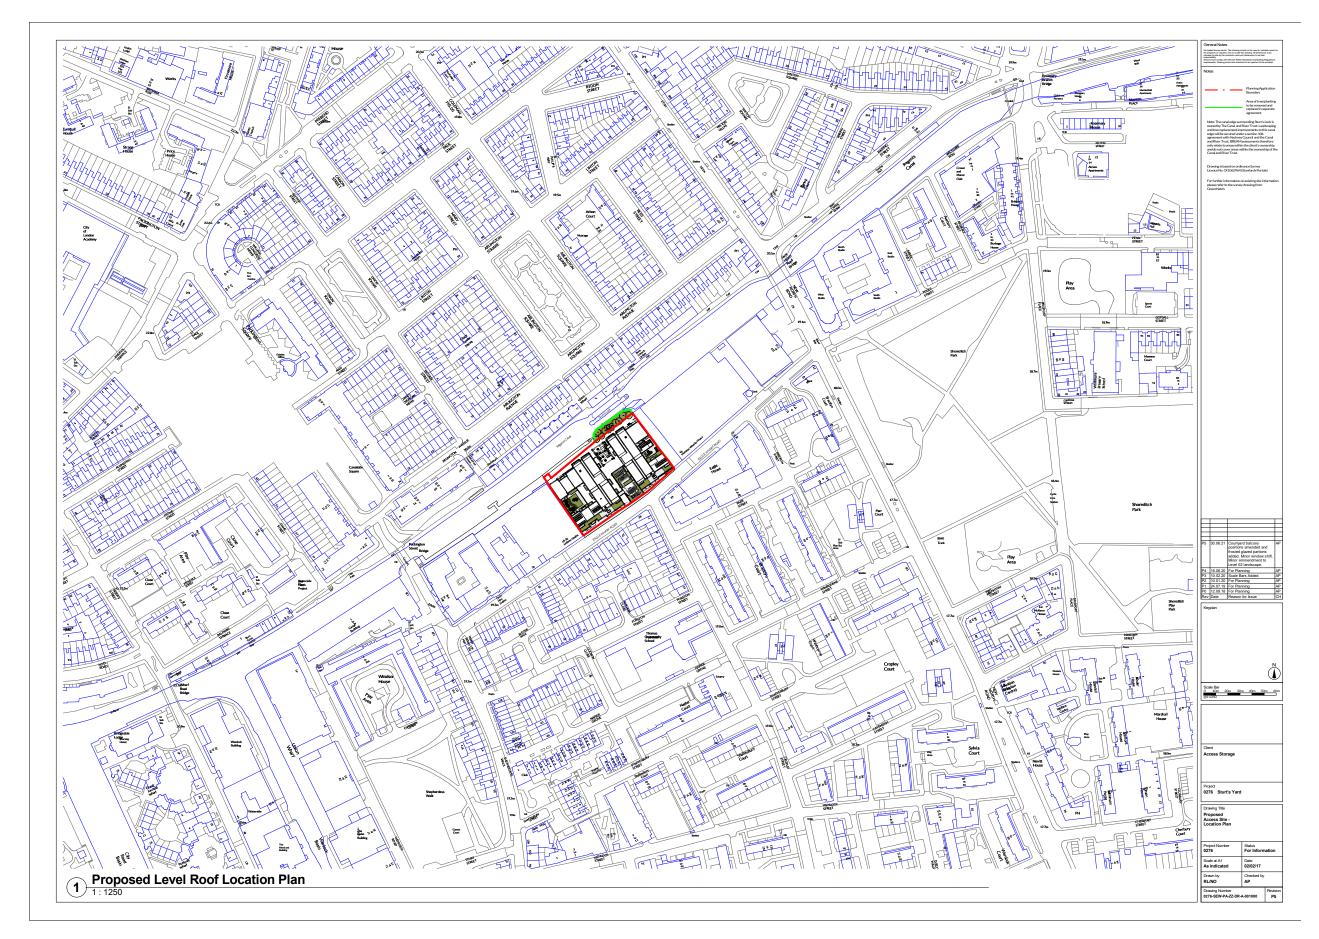


18 ~~~



STUDIO EGRET WEST

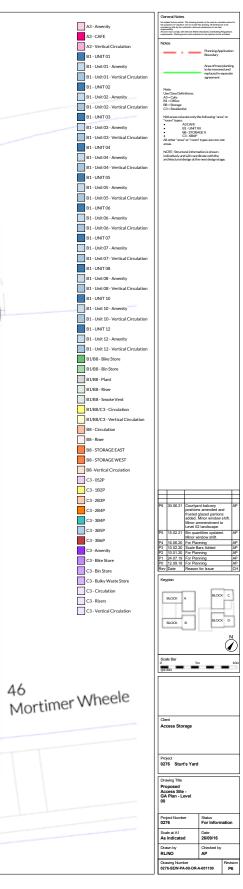

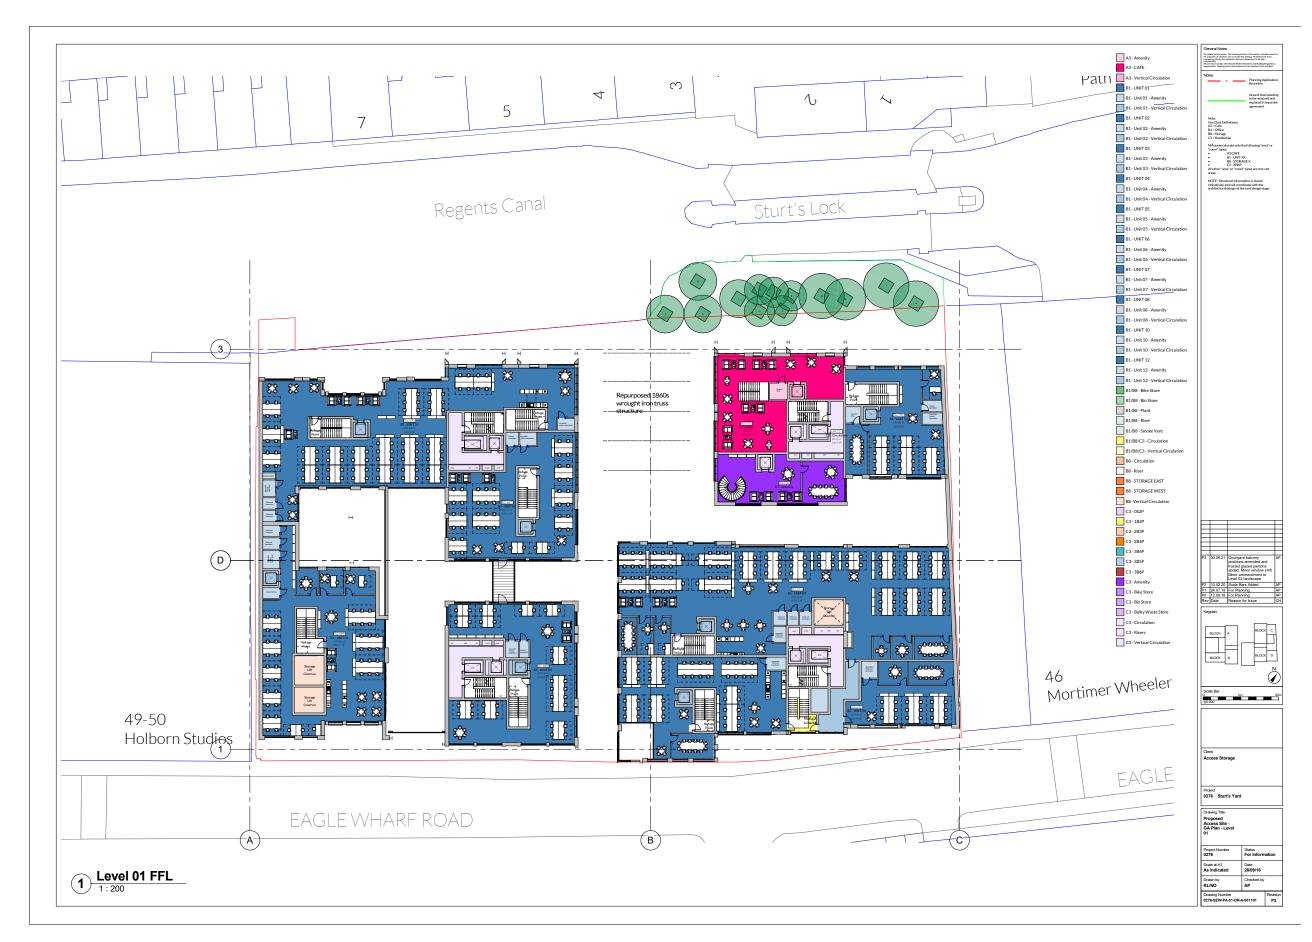

20 ~~~~



STUDIO EGRET WEST

A3 - Amenity	General Notes Norspine barroe exists. This drawing should not be used to catalable amas for the propose of visible and the Chine drawing of Chinese and the responsibility. The outside and earlier adventues to be the responsibility.
A3-CAFE	The purpose of values of the same first state on called give another to the checked on the type modelshaft and calls. Thereare, the two responsibility, At work, mad caregoly with relevant to the hybrid state to the and the requirements. Dataling ensure and creations is the reported to the and the t
A3 - Vertical Circulation	Notes
B1 - UNIT 01	Planning Application Boundary
B1 - Unit 01 - Amenity	Boundary
B1 - Unit 01 - Vertical Circulation	Area of tree/planting to be removed and replaced in separate agreement
B1 - UNIT 02	agnorment
B1 - Unit 02 - Amenity	Note:
B1 - Unit 02 - Vertical Circulation	Note: Use Class Definitions: A3 = Cafe B1 = Office B8 = Storage C3 = Residential
B1 - UNIT 03	
B1 - Unit 03 - Amenity	NIA areas calucate only the following "area" or "room" types:
B1 - Unit 03 - Vertical Circulation	 ASCAFE
B1 - UNIT 04	B1-UNTXX B8-STORAGEX C3-XB0 All other "area" or "room" types are non-net
B1 - Unit 04 - Amenity	Areas.
B1 - Unit 04 - Vertical Circulation	NOTE : Structural information is shown indicatively and will coordinate with the architectural design at the next design stage.
B1 - UNIT 05	
B1 - Unit 05 - Amenity	
B1 - Unit 05 - Vertical Circulation	
B1 - UNIT 06	
B1 - Unit 06 - Amenity	
B1 - Unit 06 - Vertical Circulation	
B1 - UNIT 07	
B1 - Unit 07 - Amenity	
B1 - Unit 07 - Vertical Circulation	
B1-UNIT 08	
B1 - Unit 08 - Amenity	
B1 - Unit 08 - Vertical Circulation	
B1 - UNIT 10	
B1 - Unit 10 - Amenity	
B1 - Unit 10 - Amenity B1 - Unit 10 - Vertical Circulation	
B1 - Unit 10 - Vertical Circulation B1 - UNIT 12	
B1 - Unit 12 - Amenity	
B1 - Unit 12 - Amenity B1 - Unit 12 - Vertical Circulation	
B1/B8 - Bike Store	
B1/B8 - Bin Store	
B1/B8 - Plant	
B1/B8 - Plant B1/B8 - Riser	
B1/B8 - Smoke Vent	
B1/B8/C3 - Circulation	
B1/B8/C3 - Vertical Circulation	
B8 - Circulation	
B8 - Riser	
B8 - STORAGE EAST	
B8 - STORAGE WEST	
B8 -Vertical Circulation	
C3-052P	
C3-1B2P	
C3 - 2B3P	
C3-2B4P C3-3B4P	P5 07.07.21 Courtyard balcony positions amended and frosted glazed partions added. Minor window shift. Minor ammendments to Level 02 landscape. AP P4 15.02.21 Bin quantifies updated. Minor window shift. AP
C3-384P	frosted glazed partions added, Minor window shift,
C3-385P	Minor ammendments to Level 02 landscape.
	P4 15.02.21 Bin quantities updated. AP Minor window shift.
C3 - Amenity C3 - Bike Store	P3 16.06.20 For Planning AP P2 10.02.20 Scale Barr Added AD
C3 - Bike Store	P1 24.07.19 For Planning AP P0 12.09.18 For Planning AP
C3 - Bulky Waste Store	Rev Date Reason for Issue CH
C3 - Bulky Waste Store	Keyplan
C3 - Circulation	
C3 - Vertical Circulation	BLOOK A BLOOK C
	BLOCK B BLOCK D
	Scale Bar 5m 100
	Cient
	Client Access Storage
	Access Storage
	Access Storage
	Access Storage Project 00276 Sturt's Yard
	Access Storage Project 0276 Sturt's Yard Dawrog Tife Pronsed
	Access Storage Poject 0276 Sturf's Yard Drawing Tife Proposed Action Content Level
	Access Storage Project 0276 Sturf's Yard Danny Tife Proposed Access Site - OA Plan - Level 02
	Access Storage Poject 0276 Sturf's Yard Drawing Tife Proposed Action Content Level
	Access Storage Project 0276 Sturf's Yard Drawing Tile Proposed Access Site Access Site Proposed Project Number For Information Status A1 Date
	Access Storage Project 0276 Sturf's Yard Drawty Tim Proposed Access Site - Covel 0276 Project Nonter 2276 Project Nonter Statis Covel Cove
	Access Storage Project 0276 Sturf's Yard Drawing Tile Proposed Access Site Access Site Proposed Project Number For Information Status A1 Date



AS - Amenity AS - CAFE AS - Vertical Circulation B1 - UNIT 03 B1 - UNIT 04 B1 - UNIT 04 B1 - UNIT 04 B1 - UNIT 05 B1 - UNIT 07 B1 - UNIT 05 B1 - U		General Notes
A. A. Arenity		
S. Lord Netrical Circulation Netrical Circulation B1 - Unit C1 Amanipulation B1 - Unit C2 Amanipulation B1 - Unit C2 Amanipulation B1 - Unit C2 Amanipulation B1 - Unit C3 Amanipulation B2 - Word C3 Amanipulation B2 - Word C3 Amanipulation B2 - Word C3	A3 - Amenity	required by A work mad usingly with relevant to that. Translanks and Building Regulations requirements. Database priors and units ators to be reputed to the architect.
A went and a construct of a second o	A3-CAFE	
11 Unit 01 Vertical Circulation In Unit 02 12 Unit 02 Amenity In Unit 03 Amenity 13 Unit 03 Amenity In Unit 03 Amenity 14 Unit 03 Amenity In Unit 03 Amenity 15 Unit 03 Amenity In Unit 03 Amenity 16 Unit 03 Amenity In Unit 03 Amenity 16 Unit 03 Amenity In Unit 03 Amenity 17 Unit 03 Amenity In Unit 03 Amenity 18 Unit 03 Amenity In Unit 03 Amenity 19 Unit 03 Amenity In Unit 03 Amenity 10 Unit 13 Amenity In Unit 13 Amenity 10 Unit 13 Amenity In Unit 13 Amenity 10 Unit 13 Amenity In Unit 13 Amenity 11 Unit 13 Amenity In Unit 13 Amenity 12 Unit 13 Amenity In Unit 13 Amenity 13 Unit 13 Amenity In Unit 13 Amenity 14 Unit 13 Amenity In Unit 13 Amenity 15 Unit 13 Amenity In Unit 13 Amenity 16 Unit 13 Amenity In Unit 14 Amenity 17 Englin	A3 - Vertical Circulation	
11 Unit 01 Vertical Circulation In Unit 02 12 Unit 02 Amenity In Unit 03 Amenity 13 Unit 03 Amenity In Unit 03 Amenity 14 Unit 03 Amenity In Unit 03 Amenity 15 Unit 03 Amenity In Unit 03 Amenity 16 Unit 03 Amenity In Unit 03 Amenity 16 Unit 03 Amenity In Unit 03 Amenity 17 Unit 03 Amenity In Unit 03 Amenity 18 Unit 03 Amenity In Unit 03 Amenity 19 Unit 03 Amenity In Unit 03 Amenity 10 Unit 13 Amenity In Unit 13 Amenity 10 Unit 13 Amenity In Unit 13 Amenity 10 Unit 13 Amenity In Unit 13 Amenity 11 Unit 13 Amenity In Unit 13 Amenity 12 Unit 13 Amenity In Unit 13 Amenity 13 Unit 13 Amenity In Unit 13 Amenity 14 Unit 13 Amenity In Unit 13 Amenity 15 Unit 13 Amenity In Unit 13 Amenity 16 Unit 13 Amenity In Unit 14 Amenity 17 Englin	B1-UNIT 01	Area of tree/planting to be removed and
 1- UNITO 2 1- UNITO 2 - UNITO 3 - UNITO 3 - UNITO 4 - UNITO 4 - UNITO 5 - UNITO 5 - UNITO 5 - UNITO 5 - UNITO 7 -	B1 - Unit 01 - Amenity	replaced in separate agreement
B1 - Unit C2 - Amenity E1 - Bit C2 - Amenity B1 - Unit C3 - Amenity E1 - Bit C2 - C2 - D2 - C2 - Bit C2 - C2 - D2 - C2 - D2 - C2 - D2 - C2 - D2 - D	B1 - Unit 01 - Vertical Circulation	Note
B1 - Unit C2 - Amenity E1 - Bit C2 - Amenity B1 - Unit C3 - Amenity E1 - Bit C2 - C2 - D2 - C2 - Bit C2 - C2 - D2 - C2 - D2 - C2 - D2 - C2 - D2 - D	B1-UNIT 02	Use Class Definitions: A3 = Cafe
B1: Unit 02 - Vertical Circulation PAthematical ended of the Unit 03 B1: UNIT 03 B1: UNIT 04 B1: UNIT 04 Dimit 03 B1: UNIT 04 Dimit 04 B1: UNIT 04 Dimit 04 B1: UNIT 05 Dimit 04		
In UNIT OF MCE: Social defauition of any interfaces of any of the social defauit		
In UNIT OF MCE: Social defauition of any interfaces of any of the social defauit		"room" types: A3CAFE
In UNIT OF MCE: Social defauition of any interfaces of any of the social defauit		B1-UNITXX B8-STORAGEX C3-XB0P
In UNIT OF MCE: Social defauition of any interfaces of any of the social defauit		All other "area" or "room" types are non-net areas.
B1: Unit 03 - Amenity B1: Unit 05 - Amenity B1: Unit 05 - Amenity B1: Unit 05 - Amenity B1: Unit 05 - Vertical Circulation B1: Unit 05 - Vertical Circulation B1: Unit 05 - Amenity B1: Unit 12 - Vertical Circulation B2: Ba: Ba: Store B1: B3: Tore Amenity B1: Unit 12 - Vertical Circulation B1: B2:		NOTE: Structural information is shown
B1 - Unit O5 - Amenity B1 - Unit O5 - Menity B1 - Unit D5 - Menity B1 - Bis Store B1/B8 - Dint B1/B8		architectural design at the next design stage.
B1: UNITOS B		
B1 - Unit D5 - Amenity B1 - Unit D5 - Verifical Circulation B1 - Unit D5 - Mennity B1 - Bins Store B288- Bins Store B270- Marcia B270- Marcia B270- Marcia B270- Marcia B270- Vertical Circulation B270- Marcia	B1 - Unit 04 - Vertical Circulation	
11 - Unit O5 - Vertical Circulation 12 - Unit O5 - Amenity 13 - Unit O5 - Amenity 13 - Unit O5 - Amenity 14 - Unit O5 - Amenity 15 - Unit O5 - Amenity 16 - Unit 15 - Amenity 16 - Unit 15 - Amenity 17 - Unit 15 - Amenity 18 - Unit 15 - Amenity 19 - Unit 15 - Vertical Circulation 19 - Bas Store 19 - Store 19 - Store Store	B1 - UNIT 05	
B1: UNITO6 III UNITO7 B1: UNITO7	B1 - Unit 05 - Amenity	
B1: Unit 06 - Amenity B1: Unit 07 - Vertical Circulation B1: Unit 12 - Amenity B1: Bails Store B1: Bails Store B1: Bails Store B1: Bails Store B1: Store Circulation B2: Store Circulation B3: Store Circulation B2: Store Circulation B	B1 - Unit 05 - Vertical Circulation	
B1 - Unit O2 - Mennity I - Unit O2 - Mennity B1 - Unit O2 - Mennity I - Unit O3 - Mennity B1 - Unit O2 - Mennity I - Unit O3 - Mennity B1 - Unit O2 - Mennity I - Unit O3 - Mennity B1 - Unit O3 - Mennity I - Unit O3 - Mennity B1 - Unit O3 - Mennity I - Unit O3 - Mennity B1 - Unit D3 - Mennity I - Unit D3 - Mennity B1 - Unit D3 - Mennity I - Unit D3 - Mennity B1 - Unit D3 - Mennity I - Unit D3 - Mennity B1 - Unit D3 - Mennity I - Unit D3 - Mennity B1 - Unit D3 - Mennity I - Unit D3 - Mennity B1 - Unit D3 - Mennity I - Unit D3 - B1 - Unit 07 - Vertical Circulation B1 - Unit 08 B1 - Unit 10 B1 - Unit 12 B1 - Bin Store B1088 - Sine Store B1088 - Sine Store B2080 - Store K Vertial B2		
11 - Unit 07 - Vertical Circulation 12 - Unit 03 - Amenity 13 - Unit 10 - Amenity 13 - Unit 10 - Amenity 14 - Unit 12 - Amenity 15 - Unit 12 - Vertical Circulation 18 - Unit 12 - Vertical Circulation 18 - Bills Store 19 - Bills 19 - Diality 19 - Bills 19 - Bills 19 - Diality		
B1 - UNITOS B2 - Basis Store B2 - Store Carculation B3 - Conduct E Loss B3 - Fondored Wort B3 - Store Carculation C3 - Store C3 - Marchily C3 -		
Louis California Constraints Louis California Louis Louis California Louis Louis California Louis Louis Louis California Louis Louis Louis California Louis Loui		
11 - Unit 03 - Vertical Circulation 13 - Unit 13 - Amenity 13 - Unit 12 - Amenity 14 - Unit 12 - Amenity 15 - Unit 12 -		
B1-UNIT 10 B1-UNIT 12 B1-Bin Store B108-Sinok Vent	-	
B1 - Unit 12 - Amenity B1 - Unit 12 - Vertical Circulation B1 - Unit 12 - Vertical Circulation B128 - Blue Store B128 - Store Store B128 - Blue Store B128 - Store Store B128 - Store Store B128 - Blue Store C1 - Store C2 - Store C2 - Store C3 - Blue Stor		
B1 - Unit 12 - Vertical Circulation B1 - Unit 12 - Vertical Circulation B1 - Unit 12 - Vertical Circulation B1 - B1 - Store B1/B8 - Flore B1/B8 - Store B1/B8 - Store C1 - Store B1 - Store C1 - Store B1 - Stor	B1 - UNIT 10	
11 - UNIT 12 13 - UNIT 12 14 - UNIT 12 15 - UNIT 12 - Amenity 15 - UNIT 1	B1 - Unit 10 - Amenity	
1. Unit 12 - Amenity B1 - Unit 12 - Vertical Circulation 11/98 - Bis-Store 12/98 - Dist-Store	B1 - Unit 10 - Vertical Circulation	
B1 - Unit 12 - Vertical Circulation B1/B8 - Bins Store B1/B8 - Din Store B1/B8 - Finat B1/B8 - Finat B1/B8 - Finat B1/B8 - Tork Vertical Circulation B8 - Circulation B8 - Store Circulation C1 - Unitical Circulation C1 - Uniti	B1 - UNIT 12	
B1 - Unit 12 - Vertical Circulation B1/B8 - Bins Store B1/B8 - Din Store B1/B8 - Finat B1/B8 - Finat B1/B8 - Finat B1/B8 - Tork Vertical Circulation B8 - Circulation B8 - Store Circulation C1 - Unitical Circulation C1 - Uniti	B1 - Unit 12 - Amenity	
B1/B8 - Bin-Store B1/B8 - Bin-Store B1/B8 - Finsh Store B1/B8 - Finsh Store B1/B8 - Sinoke Vent C3 - Sinope C3 - Ventical Circulation C3 - Ventical Circulation C3 - Ventical Circulation C3 - Ventical Circulation Careet Access Storage Pagent Nutter Soute for Coreet Access Storage Pagent Nutter Soute for Daminy Daminy Daminy Daminy Daminy Daminy Daminy Daminy </td <td></td> <td></td>		
B1/B8 -Bis Store B1/B8 -Finit B1/B8 -Finit B1/B8 -Finit B1/B8 -Finit B1/B8 - Sinker B1/B8 - Corculation B8 - Store Corculation C1 - Store Corculation B8 - Store Corculation C2 - 284P C3 - Store Corculation C3 - Store Corculation C3 - Store Corculation C3 - Store Corculation C3 - Amenity C3 - Bis Store C3 - Amenity C3 - Store Corculation C3 - Store Corculation C3 - Store Corculation C3 - Bis Store C3 - Store Corculation C3 - Mentity C3 - Mentity C3 - Store Corculation C3 - Working Corculation Cases Storage Popped C2 - Storage Popped Cases Storage Down Ty Store Storage </td <td></td> <td></td>		
B1/B3 - Plant B1/B3 - Sincer B2/B3 - Sonola Vont B2/B3/C3 - Vortical Circulation B3 - Sinchaft B3 - Vortical Circulation C1 - Sinchaft C1 - Sinchaft C2 - Salap C3 - Salap		
B1/B8 - Riser B2/B8 - Stock Vint B2/B8/G3 - Vertical Circulation B8- Riser B8 - STORACE LAST B8 - STORACE VEST B8 - STORACE VEST B8 - STORACE VEST B8 - STORACE VEST B8 - STORACE AST B8 - STORACE Conclusion B7 - Or Article Circulation C1 - StarP C2 - 283P C3 - StarP		
B1/B8 - Smoke Vent B1/B8 - Smoke Vent B2/B8/C3 - Vential Circulation B8 - Circulation B8 - Stroke Vent C3 - Ventical Circulation C3 - Ventical Circulation C3 - Ventical Circulation Carer Access Storage Paget Netter Store Corer Access Storage Paget Netter Store On Paget Netter Paget Netter Store On Paget Netter Paget Netter Paget Netter Store On Pag		
B1/BB/C3 - Circulation B2/BB/C3 - Circulation B8 - Riser B8 - Store Circulation B8 - TORACE EAST B8 - TORACE WEST B8 - Vertical Circulation C3 - 252P C3 - 252P C3 - 254P C3 - 254P C3 - 364P C3 - Store C3 - Bits Store C3 - Bits Store C3 - Bits Store C3 - Circulation C3 - Normity C3 - Normity C3 - Store C3 - Normity C3 - Store C3 - Bully Wate Store C3 - Circulation C3 - Vertical Circulation C3 - Vertical Circulation C3 - Vertical Circulation Caces Storage Popoet B2276 Store Yeard Popoet B2276 B276 B300 - Vertical Circulation B276 B300 - Vertical Circulation		
B1/BB/C3 - Vertical Circulation B3: - Circulation B3: - Circulation B3: - STORACE WEST B3: - Vertical Circulation C:- 052P C:- 052P C:- 363P D:- 1002 D:- 1002 <td< td=""><td></td><td></td></td<>		
B8 - Circulation B8 - Sire B8 - STORAGE LAST B8 - STORAGE WEST B8 - Vertical Circulation C1 - 022P C2 - 283P C3 - 284P C3 - 384P C3 - 384P C3 - 384P C3 - 384P C3 - 484P C3 - 4	B1/B8/C3 - Circulation	
B8 - Riter B9 - STORAGE LAST B9 - STORAGE LAST B9 - STORAGE LAST B9 - STORAGE WEST C3 - 2024 C3 - 2024	B1/B8/C3 - Vertical Circulation	
BB - STORAGE MST BB - Vertical Circulation (2 - 052P (2 - 284P (2 - 284P (2 - 384P (2 - 384P	B8 - Circulation	
BB - STORAGE MST BB - Vertical Circulation (2 - 052P (2 - 284P (2 - 284P (2 - 384P (2 - 384P	B8 - Riser	
B8 - STORACE WEST B9 - Vertical Circulation C3 - 652P C3 - 253P C3 - 254P C3 - 364P		
B8 -Vertical Circulation G1 - 052P G2 - 253P G2 - 264P G3 - 264P G3 - 264P G3 - 265P G4 - 265 G4		
C3 - 652P C3 - 122P C3 - 228P C3 - 284P C3 - 384P C3 - 384P		
C3 - 182P Image: Care State Stat		
C3 - 283P PS 07 - 07 - 21 Control of the sector of t		
G 264P P5 07:07 Compete balances PF G 364P		
C3 - Steely C3 - S		P5 07.07.21 Courtyard balcony AP positions amended and
C3 - Steely C3 - S		frosted glazed partions added. Minor window shift.
C3 - Steely C3 - S		Minor ammendments to Level 02 landscape.
C Anomity Point Construction		Minor window shift
Control C		P3 16.06.20 For Planning AP P2 10.02.20 Scale Bars Articled
Control C		P1 24.07.19 For Planning AP
C3 - Bulky Wate Store C3 - Circulation C3 - Vertical Circulation C1 - Vertical Circle Circulation C1 - Vertical Circulation		Rev Date Reason for Issue CH
C3 - Budky Waste Store C3 - Circulation C3 - Vertical Circulation C3 - Vertical Circulation Scale fabr Circulation C	C3 - Bin Store	
C3 - Risers C3 - Vertical Circulation C3 - Ver	C3 - Bulky Waste Store	
C3 - Risers C3 - Vertical Circulation C3 - Ver	C3 - Circulation	
C3 - Vertical Circulation	C3 - Risers	
Incor n Incor N Scale for Incor Incor Incor Distribution Distribution Distribution Distribution	C3 - Vertical Circulation	
South Bar South Bar Board Bar South Board Bar South Chert Access Storage Caret Access Storage Drawing Title Proposed Proposed Access Storage Drawing Title Proposed Access Storage For Information Board At Date of Proposed Access Storage Convert Title Proposed Access Storage Drawing Title South At Date of Proposed Access Storage Drawing Number Drawing Version Down Tyr Drawing Version Drawing Number Previous		BLOCK B BLOCK D
Ciert In State States Ciert Access Storage Proped 276 Sturt's Yard Ciert Access Storage Proped States Ciert Access Storage Ciert Access Storage Proped States Ciert Access Storage Ciert Access Storage Cier		
Client Client Access Storage Propost 0276 Sturf's Yard Drawing Tife Proposa Stor- CA PRIN-Level 03 Proposa Stor- CA PRIN-Level 03 Proposa Stor- CA PRIN-Level 03 Date at J. Date Storage Proposa Stor- CA PRIN-Level 03 Date Storage Date Storage Proposa Storag		
Access Storage		@1.200
Access Storage		
Project 0276 Sturf's Yard 0276 Sturf's Yard Crowry Tite Proposed Access Site O 376 - Level 0 376 - Level 0 376 - Fro Information Scale d A1 As Indicated Date 1 June 1 County Cocked by RLNO Crocked by RLNO Crocked by Provision		
2276 Sturt's Yard Drawing Title Proposed Proposed Ibits - GA PRin - Level G3 Status Project Nameter For Information State AL Date of 10 Proposed State AL Date of 10 Proposed Date of AL Date of 10 Proposed		
2276 Sturt's Yard Drawing Title Proposed Proposed Ibits - GA PRin - Level G3 Status Project Nameter For Information State AL Date of 10 Proposed State AL Date of 10 Proposed Date of AL Date of 10 Proposed		Project
Proposed Access 34th - Sealar Of Fem - Level Project Nancter Scalar d. A1 Date of A1 Dat		
Proposed Access 34th - Sealar Of Fem - Level Project Nancter Scalar d. A1 Date of A1 Dat		
Access Site - OA Plan - Level Project Number 276 For Information Status S		Proposed
03 Project Names 2276 For Information Scele A1 As Indicated Dawn by RLNO Dawn Sy AP Project Names Dawn Sy AP Project Names Project Names Dawn Dawn Dawn Project Names Project Names Pr		Access Site -
0276 For Information Scale at A1 Date As indicated Date Down by Checked by RLNNO AP Down Wanters Revision		03
0276 For Information Scale at A1 Date As indicated Date Down by Checked by RLNNO AP Down Wanters Revision		
Senis A Ai As indicated 30/11/16 Drawn ty RLNO AP Downy Number Relation		Project Number Status 0276 For Information
As indicated 30/11/16 Drawn by Checked by RLINO AP Drawing Number Peulsion		
RL/NO AP Drawing Number Revision		
Drawing Number Revision		



STUDIO EGRET WEST

	General Notes
A3 - Amenity	Normalized before works. The distribution of the cont is called a many by
A3-CAFE	The purposes of valuation Darred water Weak Manage Af-Adomesians Later Cardwale on the JP for a contrabute water and -indexessaria. In the Theor responsibility At and cancel charge untransversel Bibles Transitionits and Railing Maguations (respinements). Charangements and contestants is the reputide to the autofated.
A3 - Vertical Circulation	Notes
B1 - UNIT 01	Planning Application Boundary
B1 - Unit 01 - Amenity	Area of tree/planting to be removed and replaced in separate agreement
B1 - Unit 01 - Vertical Circulation	replaced in separate agreement
B1 - UNIT 02	Note: Use Class Definitions:
B1 - Unit 02 - Amenity	Use ClassDefrottom: A3 = Cafe B1 = Office B8 = Storage C3 = Residential
B1 - Unit 02 - Vertical Circulation	
B1 - UNIT 03	NIA areas calucate only the following "area" or "room" types:
B1 - Unit 03 - Amenity	A3CAFE A3CAFE B1-UNTXX B5-STORAGEX C3-XB8P All other "area" or "room" types are non-net
B1 - Unit 03 - Vertical Circulation	C3-XEXP All other "area" or "room" types are non-net areas
B1 - UNIT 04	areas.
B1 - Unit 04 - Amenity	NOTE: Structural information is shown indicatively and will coordinate with the architectural design at the next design stage.
B1 - Unit 04 - Vertical Circulation	
B1 - UNIT 05	
B1 - Unit 05 - Amenity	
B1 - Unit 05 - Vertical Circulation	
B1 - UNIT 06	
B1 - Unit 06 - Amenity	
B1 - Unit 06 - Vertical Circulation	
B1 - UNIT 07	
B1 - Unit 07 - Amenity	
B1 - Unit 07 - Vertical Circulation	
B1 - UNIT 08	
B1 - Unit 08 - Amenity B1 - Unit 08 - Vertical Circulation	
B1 - Unit 08 - Vertical Circulation B1 - UNIT 10	
B1 - Unit 10 - Amenity	
B1 - Unit 10 - Vertical Circulation	
B1- UNIT 12	
B1- Unit 12 - Amenity	
B1 - Unit 12 - Vertical Circulation	
B1/B8 - Bike Store	
B1/B8 - Bin Store	
B1/B8 - Plant	
B1/B8 - Riser	
B1/B8 - Smoke Vent	
B1/B8/C3 - Circulation	
B1/B8/C3 - Vertical Circulation	
B8 - Circulation	
B8 - Riser	
B8 - STORAGE EAST	
B8 - STORAGE WEST	
B8 - Vertical Circulation	
C3-052P	
C3 - 1B2P	
C3 - 2B3P	
C3-2B4P	P5 07.07.21 Courtyard balcony AP positions amended and
C3 - 3B4P	frosted glazed partions added. Minor window shift.
C3 - 3B5P	P5 07.07.21 Courtyard balcony AP positions amended and frosted glazed partions added. Minor window shift. Minor amendments to Level 02 landscape. P4 15.02.21 Bin quantities updated. AP
C3-3B6P	F4 10.02.21 Bill qualities updated. p4
C3 - Amenity	P2 10.02.20 Scale Bars Added AP
C3 - Bike Store	P2 10.02.20 Scale Bars Added AP P1 24.07.19 For Planning AP P0 12.09.18 For Planning AP
C3 - Bike Store C3 - Bin Store	Rev Date Reason for Issue CH
C3 - Bilke Store C3 - Bin Store C3 - Bulky Waste Store	P2 10.02.20 Scale Bars Ädded AP P1 24.07.19 For Planning AP P0 12.09.18 For Planning AP Rev Date Reason for Issue CH Keyplan Keyplan Keyplan Keyplan
C3 - Bike Store C3 - Bin Store C3 - Bulky Waste Store C3 - Circulation	Rev Date Reason for Issue (CH
C3 - Bike Store C3 - Bin Store C3 - Bulky Waste Store C3 - Griculation C3 - Circulation C3 - Risers	Rev Date Reason for Issue CH
C3 - Bike Store C3 - Bin Store C3 - Bulky Waste Store C3 - Circulation	Rev Date Reason for Issue (CH
C3 - Bike Store C3 - Bin Store C3 - Bulky Waste Store C3 - Girculation C3 - Circulation C3 - Risers	Rev Date Reason for Issue CH Keylan BLOCK A BLOCK C
C3 - Bike Store C3 - Bin Store C3 - Bulky Waste Store C3 - Griculation C3 - Circulation C3 - Risers	Rev Date Reason for Issue (CH
C3 - Bike Store C3 - Bin Store C3 - Bulky Waste Store C3 - Griculation C3 - Circulation C3 - Risers	Rev (Date Reason for Issue (CH Kepten BLOOX A BLOOX C BLOOX B BLOOX C BLOOX C
C3 - Bike Store C3 - Bin Store C3 - Bulky Waste Store C3 - Griculation C3 - Circulation C3 - Risers	Rev[Date Reason for Saue [04]
C3 - Bike Store C3 - Bin Store C3 - Bulky Waste Store C3 - Griculation C3 - Circulation C3 - Risers	Rev[Date Reason for Saue [04]
C3 - Bike Store C3 - Bin Store C3 - Bulky Waste Store C3 - Griculation C3 - Circulation C3 - Risers	Rev[Date Reason for Issue [04]
C3 - Bike Store C3 - Bin Store C3 - Bulky Waste Store C3 - Griculation C3 - Circulation C3 - Risers	Rev[Date Reason for Saue [04]
C3 - Bike Store C3 - Bin Store C3 - Bulky Waste Store C3 - Griculation C3 - Circulation C3 - Risers	Rev[Date Reason for Saue [04]
C3 - Bike Store C3 - Bin Store C3 - Bulky Waste Store C3 - Circulation C3 - Circulation C3 - Risers	Rev_Dos Reson for issue (24) Kopsian III.coc III.coc III.coc III.coc III.coc III.coc III.coc III.coc III.coc III.coc III.coc III.coc III.coc III.coc Boate flar III.coc III.coc Boate flar Son III.coc Drawing Title Proposed Access Stars Drawing Title Proposed Access Stars Boate An Coste Coste As indicated Doste Coste
C3 - Bike Store C3 - Bin Store C3 - Bulky Waste Store C3 - Circulation C3 - Circulation C3 - Risers	Rev_Dok Reacon for Save (CH Kopsian Roopian R
C3 - Bike Store C3 - Bin Store C3 - Bulky Waste Store C3 - Circulation C3 - Circulation C3 - Risers	Rev[Data Reacon for issue [04] Kepsian Kepsian Record and an analysis and an




	General Notes
A3 - Amenity	Nonspired Service enclos. This classing should not be used to calculate areas for the purposes of volumities. During tables the distancy, R-dimensions in the checked on while by the controllation and dimensions. In the ther
A3 - CAFE	Receipted lands with the data set of the same lands and the same lands of the same l
A3 - Vertical Circulation	NORES
B1 - UNIT 01	Planning Application Boundary
B1 - Unit 01 - Amenity	
B1 - Unit 01 - Vertical Circulation	Area of tree/planting to be removed and replaced in separate agreement
B1-UNIT 02	agreement
	Note:
B1 - Unit 02 - Amenity	Noto: Use Class Definitions: A3 – Cafe B1 = Office B8 = Storage C3 = Residential
B1 - Unit 02 - Vertical Circulation	B1 = Office B8 = Storage C2 = Residential
B1 - UNIT 03	NIA areas calucate only the following "area" or
B1 - Unit 03 - Amenity	
B1 - Unit 03 - Vertical Circulation	A3CAFE A3CAFE B1-UNITXX B3-STORAGEX C3-XBVP All other "area" or "room" types are non-net
_	C3 - XBN ² All other "area" or "room" types are non-net
B1 - UNIT 04	NOTE : Structural information is shown
B1 - Unit 04 - Amenity	NOTE : Structural information is shown indicatively and will coordinate with the architectural design at the next design stage.
B1 - Unit 04 - Vertical Circulation	
B1 - UNIT 05	
B1 - Unit 05 - Amenity	
B1 - Unit 05 - Vertical Circulation	
B1 - UNIT 06	
B1 - Unit 06 - Amenity	
B1 - Unit 06 - Vertical Circulation	
B1 - UNIT 07	
B1 - Unit 07 - Amenity	
B1 - Unit 07 - Vertical Circulation	
B1 - UNIT 08	
B1 - Unit 08 - Amenity	
B1 - Unit 08 - Vertical Circulation	
B1 - UNIT 10	
B1 - Unit 10 - Amenity	
B1 - Unit 10 - Vertical Circulation	
B1 - UNIT 12	
B1 - Unit 12 - Amenity	
B1 - Unit 12 - Amenity B1 - Unit 12 - Vertical Circulation	
B1/B8 - Bike Store	
B1/B8 - Bin Store	
B1/B8 - Plant	
B1/B8 - Riser	
B1/B8 - Smoke Vent	
B1/B8/C3 - Circulation	
B1/B8/C3 - Vertical Circulation	
B8 - Circulation	
B8 - Circulation B8 - Riser	
=	
B8 - Riser B8 - STORAGE EAST	
B8 - Riser B8 - STORAGE EAST B8 - STORAGE WEST	
B8 - Riser B8 - STORAGE EAST B8 - STORAGE WEST B8 - Vertical Circulation	
B8 - Riser B8 - STORAGE EAST B8 - STORAGE WEST B8 - Vertical Circulation C3 - 0S2P	
B8-Riser B8-STORAGE EAST B8-STORAGE WEST B8-Vertical Circulation C3-052P C3-182P	
B8 - Riser B8 - STORAGE EAST B8 - STORAGE VEST B8 - Vertical Circulation C3 - 052P C3 - 182P C3 - 283P	
B8 - Riser B8 - STORAGE EAST B8 - STORAGE WEST B8 - Vertical Circulation C3 - 052P C3 - 182P	P5 07 07 21 Countent balcow AP
B8 - Riser B8 - STORAGE EAST B8 - STORAGE VEST B8 - Vertical Circulation C3 - 052P C3 - 182P C3 - 283P	P5 07.721 Coartyont balcory policing semended and P5 07.721 Coartyont balcory
B8 - Riser B8 - STORAGE EAST B8 - STORAGE WEST B8 - Vertical Circulation C3 - 032P C3 - 283P C3 - 284P	P5 07.07.21 Coungest balony AP Instant glause partners to Alder Aller y and an anti- adada Marry antione to to
B8 - Riser B8 - STORAGE LAST B8 - STORAGE WEST B8 - Storal Circulation C3 - 052P C3 - 182P C3 - 283P C3 - 283P C3 - 354P	P5 07.07.21 Courtput balcony AP positica amended and balcon and the amendments to More among the amendments for B4 19 07 21 Balconterminance AP
B8 - Riser B8 - STORAGE EAST B8 - STORAGE WEST B8 - Vertical Circulation C3 - 0289 C3 - 2849 C3 - 2849 C3 - 3849	Positions amended and frosted glazed partions added. Minor window shift. Minor ammendments lo Level 02 inandscape. P4 15.02.21 Bin quantities updated. AP Minor window shift
B8 - Riser B8 - STORACE LAST B8 - STORACE WEST B8 - Verical Circulation C3 - 052P C3 - 102P C3 - 052P C3 - 303P C3 - 304P C3 - 306P C3 - Amenity	P3 10.00.20 Pol Planning PP
B8 - Riser B8 - STORAGE LAST B8 - STORAGE WEST B8 - STORAGE (Civalianon C3 - 662P C3 - 182P C3 - 283P C3 - 384P C3 - 386P C3 - 886 Store	P3 10.00.20 Pol Planning PP
B8 - Riser B8 - STORAGE EAST B8 - STORAGE WEST B8 - STORAGE WEST B8 - Vertal Circulation C3 - 052P C3 - 182P C3 - 283P C3 - 384P C3 - 886 Store C3 - 886 Store C3 - 886 Store	P3 10.00.20 For Planning AP P2 10.02.20 Scale Bars Added AP P1 24.07.19 For Planning AP
B8 - Riser B8 - STORAGE EAST B8 - STORAGE WEST B8 - STORAGE WEST B8 - Vertical Circulation C3 - 022P C3 - 102P C3 - 2084P C3 - 3084P C3 - 5084 Store C3 - Bike Store C3 - Bully Waste Store	P3 10.00.20 Pol Planning PP
B8 - Riser B8 - STORACE EAST B8 - STORACE EAST B8 - Vertical Circulation C3 - 052P C3 - 182P C3 - 283P C3 - 384P C3 - 386P C3 - 886 Store C3 - 886 Store	CS 10:00.002 PO Failling AP P1 10:02:02 Scale Bars Added AP P1 24:07:19 For Flaming AP P0 12:09:18 For Flaming AP Rev Date Reason for Issue CH Koyelan CH CH CH
B8 - Riser B8 - STORAGE EAST B8 - STORAGE WEST B8 - STORAGE WEST B8 - Vertical Circulation C3 - 022P C3 - 102P C3 - 2084P C3 - 3084P C3 - 5084 Store C3 - Bike Store C3 - Bully Waste Store	P3 10:02:0 Scale Bars Added AP P1 24:07:19 For Planning AP P0 12:09:18 For Planning AP P0 12:09:18 For Planning AP Rev Date Reason for Issue CH
B8 - Riser B8 - STORACE LAST B8 - STORACE WEST B8 - STORACE (rouldion C3 - 052P C3 - 1122P C3 - 1122P C3 - 2142P C3 - 3153P C3 - 3154P C3 - 5164 Store C3 - 516 Store	Co 10.0020 Co Added AP 22 10.0020 Scale Bars Added AP P1 24.07.19 For Manning AP P0 12.06.18 For Manning AP Rev Date Reason for Issue CH Kogelan BLOCK A BLOCK
B8 - Riser B8 - STORAGE LAST B8 - STORAGE WEST B8 - STORAGE (Civalianon C3 - 662P C3 - 1122P C3 - 2033P C3 - 2034P C3 - 3084P C3 - 3084P C3 - 3084P C3 - 3084P C3 - Bike Store C3 - Risers	P2 104.20 Scate Barr Added AP P1 20.11 For Penning AP P2 20.11 For Penning AP P0 120.01 For Penning AP Rev Date Rescon for taxes CH Keyplan Record of taxes CH
B8 - Riser B8 - STORAGE LAST B8 - STORAGE WEST B8 - STORAGE (Civalianon C3 - 662P C3 - 1122P C3 - 2033P C3 - 2034P C3 - 3084P C3 - 3084P C3 - 3084P C3 - 3084P C3 - Bike Store C3 - Risers	P2 100.225 Scale Sar Added AP P3 20.025 Scale Sar Added AP P0 12.021 Scale Sar Added AP P0 12.021 Scale Sar Added AP P0 12.021 Scale Sar Added AP Per Date Reason for Issue CH Kopkin BLOCX A
B8 - Riser B8 - STORAGE KAST B8 - STORAGE WEST B8 - STORAGE WEST B8 - Vertical Civalianon C3 - 082P C3 - 1122P C3 - 283P C3 - 3084P C3 - Bike Store C3 - Risers	Resource
B8 - Riser B8 - STORAGE KAST B8 - STORAGE WEST B8 - STORAGE WEST B8 - Vertical Civalianon C3 - 082P C3 - 1122P C3 - 283P C3 - 3084P C3 - Bike Store C3 - Risers	P2 104.20 Scate Barr Added AP P1 20.11 For Penning AP P2 20.11 For Penning AP P0 120.01 For Penning AP Rev Date Rescon for taxes CH Keyplan Record of taxes CH
B8 - Riser B8 - STORAGE LAST B8 - STORAGE WEST B8 - STORAGE (Civalianon C3 - 662P C3 - 1122P C3 - 2033P C3 - 2034P C3 - 3084P C3 - 3084P C3 - 3084P C3 - 3084P C3 - Bike Store C3 - Risers	P2 100 200 State Tark P1 240 719 Penering AP P3 100 18 For Penering AP P3 100 18 For Penering AP P4 100 18 For Penering Penering P4 P4 Penering Penering Penering Penering P4 P4 Penering Penering Penering Penering Penering P4 P4 Penering Penering Penering Penering Pe
B8 - Riser B8 - STORAGE LAST B8 - STORAGE WEST B8 - STORAGE (Civalianon C3 - 662P C3 - 1122P C3 - 2033P C3 - 2034P C3 - 3084P C3 - 3084P C3 - 3084P C3 - 3084P C3 - Bike Store C3 - Risers	12 100 202 Solar Eller Added APP 17 120 47:19 Pearing AP 17 120 47:19 Pearing AP 17 120 18 For Pearing AP 18 Reason for State CH AP 10 120 18 For Pearing AP 10 120 18 10 AP AP 10 120 18 10 AP AP 10 120 19 120 19 10 AP 10 120 19 120 19 10
B8 - Riser B8 - STORAGE LAST B8 - STORAGE WEST B8 - STORAGE (Civalianon C3 - 662P C3 - 1122P C3 - 2033P C3 - 2034P C3 - 3084P C3 - 3084P C3 - 3084P C3 - 3084P C3 - Bike Store C3 - Risers	P2 100 202 Solar Bins Addot APP P1 24.07 10 Ferring AP AP P0 12.06 18 For Penning AP Registra Chi Record for Solar AP Rocc A B Chi B Rocc B B B D D N B B B D D N Solar Her B B B D
B8 - Riser B8 - STORAGE LAST B8 - STORAGE WEST B8 - STORAGE (Civalianon C3 - 662P C3 - 1122P C3 - 2033P C3 - 2034P C3 - 3084P C3 - 3084P C3 - 3084P C3 - 3084P C3 - Bike Store C3 - Risers	12 100 202 Solar Eller Added APP 17 120 47:19 Pearing AP 17 120 47:19 Pearing AP 17 120 18 For Pearing AP 18 Reason for State CH AP 10 120 18 For Pearing AP 10 120 18 10 AP AP 10 120 18 10 AP AP 10 120 19 120 19 10 AP 10 120 19 120 19 10
B8 - Riser B8 - STORAGE LAST B8 - STORAGE WEST B8 - STORAGE (Civalianon C3 - 662P C3 - 1122P C3 - 2033P C3 - 2034P C3 - 3084P C3 - 3084P C3 - 3084P C3 - 3084P C3 - Bike Store C3 - Risers	P2 002.02 State Barr Addet AP P2 207.03 Big Paining AP P0 12.03.18 For Paining Paining P0 12.03.18 For Paining Pain
B8 - Riser B8 - STORAGE LAST B8 - STORAGE WEST B8 - STORAGE (Civalianon C3 - 662P C3 - 1122P C3 - 2033P C3 - 2034P C3 - 3084P C3 - 3084P C3 - 3084P C3 - 3084P C3 - Bike Store C3 - Risers	P2 002.02 State Barr Addet AP P2 207.03 Big Paining AP P0 12.03.18 For Paining Paining P0 12.03.18 For Paining Pain
B8 - Riser B8 - STORAGE KAST B8 - STORAGE WEST B8 - STORAGE WEST B8 - Vertical Civalianon C3 - 082P C3 - 1122P C3 - 283P C3 - 3084P C3 - Bike Store C3 - Risers	P2 002.02 State Barr Addet AP P2 207.03 Big Paining AP P0 12.03.18 For Paining Paining P0 12.03.18 For Paining Pain
B8 - Riser B8 - STORAGE LAST B8 - STORAGE WEST B8 - STORAGE (Civalianon C3 - 662P C3 - 1122P C3 - 2033P C3 - 2034P C3 - 3084P C3 - 3084P C3 - 3084P C3 - 3084P C3 - Bike Store C3 - Risers	P2 100:200 Source Text Adde APE P1 20:701 For Pearing APE P6 12:00:10 For Pearing APE P6 10:00:10 For Pearing APE ROCC 0 0 0 0 ROCC 0 0 0 0 N 0 0 0 0 0 Solid Thr 50:00 50:00 0 0 0
B8 - Riser B8 - STORAGE LAST B8 - STORAGE WEST B8 - STORAGE (Civalianon C3 - 662P C3 - 1122P C3 - 2033P C3 - 2034P C3 - 3084P C3 - 3084P C3 - 3084P C3 - 3084P C3 - Bike Store C3 - Risers	P2 100 200 South Tiere Andee APP P3 120 200 South Tiere Andee APP P3 120 200 South Tiere Andee APP P3 120 200 South Tiere Andee APP P4 120 200 Tiere Andee APP P4 120 200 Tiere Andee APP P4 120 200 Tiere Andee APP South Bar 100 100 M South Bar 100 100 100 100 100 100
B8 - Riser B8 - STORAGE KAST B8 - STORAGE WEST B8 - STORAGE WEST B8 - Vertical Civalianon C3 - 082P C3 - 1122P C3 - 283P C3 - 3084P C3 - Bike Store C3 - Risers	P2 100:200 Source Text Adde APE P1 20:701 For Pearing APE P6 12:00:10 For Pearing APE P6 10:00:10 For Pearing APE ROCC 0 0 0 0 ROCC 0 0 0 0 N 0 0 0 0 0 Solid Thr 50:00 50:00 0 0 0
B8 - Riser B8 - STORAGE KAST B8 - STORAGE WEST B8 - STORAGE WEST B8 - Vertical Civalianon C3 - 082P C3 - 1122P C3 - 283P C3 - 3084P C3 - Bike Store C3 - Risers	P2 100 200 South Tiere Andee APP P3 120 200 South Tiere Andee APP P3 120 200 South Tiere Andee APP P3 120 200 South Tiere Andee APP P4 120 200 Tiere Andee APP P4 120 200 Tiere Andee APP P4 120 200 Tiere Andee APP South Bar 100 100 M South Bar 100 100 100 100 100 100
B8 - Riser B8 - STORAGE KAST B8 - STORAGE WEST B8 - STORAGE WEST B8 - Vertical Civalianon C3 - 082P C3 - 1122P C3 - 283P C3 - 3084P C3 - Bike Store C3 - Risers	P2 100 200 South Tiere Andee APP P3 120 200 South Tiere Andee APP P3 120 200 South Tiere Andee APP P3 120 200 South Tiere Andee APP P4 120 200 Tiere Andee APP P4 120 200 Tiere Andee APP P4 120 200 Tiere Andee APP South Bar 100 100 M South Bar 100 100 100 100 100 100
B8 - Riser B8 - STORAGE KAST B8 - STORAGE WEST B8 - Verical Civalianon C3 - 682P C3 - 182P C3 - 283P C3 - 384P C3 - 384P C3 - 386P C3 - 886P C3 - Bike Store C3 - Bike Store C3 - Bike Store C3 - Bike Store C3 - Caulation C3 - Risers	P2 100 200 State Tare Added P2 100 200 State Tare Added P3 120 00 State Tare Added P3 120 00 State Tare Added P4 120 00 State Tare Added P5 120 State Tare Added <
B8 - Riser B8 - STORAGE KAST B8 - STORAGE WEST B8 - Verical Civalianon C3 - 682P C3 - 182P C3 - 283P C3 - 384P C3 - 384P C3 - 386P C3 - 886P C3 - Bike Store C3 - Bike Store C3 - Bike Store C3 - Bike Store C3 - Caulation C3 - Risers	P2 000 200 Source Text Addet APE P2 000 200 Source Text Addet APE P3 02 00 100 For Pearing APE P3 02 00 100 For Pearing APE P4 100 100 For Pearing APE ROCK 0 BOE 0 ROCK 0 BOE 0 P4 0 Source 0 P4 0 Source 0 P4 0 Source 0 P4 0 Source 0 P4 0
B8 - Riser B8 - STORAGE KAST B8 - STORAGE WEST B8 - Verical Civalianon C3 - 682P C3 - 182P C3 - 283P C3 - 384P C3 - 384P C3 - 386P C3 - 886P C3 - Bike Store C3 - Bike Store C3 - Bike Store C3 - Bike Store C3 - Caulation C3 - Risers	P2 002.00 South Tiere Addee APP P2 02.00 For Parring AP P3 02.00 For Parring AP P4 02.00 Incode D Incode 0 Incode D Incode <t< td=""></t<>
B8 - Riser B8 - STORAGE KAST B8 - STORAGE WEST B8 - Verical Civalianon C3 - 682P C3 - 182P C3 - 283P C3 - 384P C3 - 384P C3 - 386P C3 - 886P C3 - Bike Store C3 - Bike Store C3 - Bike Store C3 - Bike Store C3 - Caulation C3 - Risers	P2 002.02 South Time Added P2 207.03 For Parring P3 02.00 For Parring P3 02.00 For Parring P3 02.00 For Parring P3 02.00 For Parring P4 02.00 For Parring Parring For Parring Parring For Parring Parring For Parring
B8 - Riser B8 - STORAGE KAST B8 - STORAGE WEST B8 - Verical Civalianon C3 - 682P C3 - 182P C3 - 283P C3 - 384P C3 - 384P C3 - 386P C3 - 886P C3 - Bike Store C3 - Bike Store C3 - Bike Store C3 - Bike Store C3 - Caulation C3 - Risers	P2 002.02 South Time Added P2 207.03 For Parring P3 02.00 For Parring P3 02.00 For Parring P3 02.00 For Parring P3 02.00 For Parring P4 02.00 For Parring Parring For Parring Parring For Parring Parring For Parring
B8 - Riser B8 - STORAGE KAST B8 - STORAGE WEST B8 - Verical Civalianon C3 - 682P C3 - 182P C3 - 283P C3 - 384P C3 - 384P C3 - 386P C3 - 886P C3 - Bike Store C3 - Bike Store C3 - Bike Store C3 - Bike Store C3 - Caulation C3 - Risers	P2 000 200 Source Text Addet APE P2 000 200 Source Text Addet APE P3 02 00 100 For Pearing APE P3 02 00 100 For Pearing APE P4 02 00 For Pearing APE P4 02 00 For Pearing APE RCC 0 0 0 0 RCC 0 0 0 0 RCC 0 0 0 0 Pacces 0 0 0 0 Pacote 0
B8 - Riser B8 - STORAGE KAST B8 - STORAGE WEST B8 - Verical Civalianon C3 - 682P C3 - 182P C3 - 283P C3 - 384P C3 - 384P C3 - 386P C3 - 886P C3 - Bike Store C3 - Bike Store C3 - Bike Store C3 - Bike Store C3 - Caulation C3 - Risers	P2 000 200 Escar Barr Adde App P2 200 200 Escar Barr Adde App P3 200 10 Escar Barr Adde App P3 100 10 Escar Barr Adde App P5 100 10 Escar Barra App P6 100 10 Escar Barra App P6 100 10 Escar Barra App P1 200 10 Escar Barra App Rocc 0 0 0 Rocc 0 0 0 Rocc 0 0 0 Scate Bar 0 0 0 Scate Bar 0 0 0 V 0 0 0 0 Scate Bar 0 0 0 0 V 0 0 0 0 0 Scate Bar 0 0 0 0 0 V 0 0 0 0 0 0 Scate Bar 0 0 0
B8 - Riser B8 - STORAGE KAST B8 - STORAGE WEST B8 - Verical Civalianon C3 - 682P C3 - 182P C3 - 283P C3 - 384P C3 - 384P C3 - 386P C3 - 886P C3 - Bike Store C3 - Bike Store C3 - Bike Store C3 - Bike Store C3 - Caulation C3 - Risers	Page 100 2000 Exam Ellen Advest Page 100 2000 Exam Ellen Advest <t< th=""></t<>
B8 - Riser B8 - STORAGE KAST B8 - STORAGE WEST B8 - Verical Civalianon C3 - 682P C3 - 182P C3 - 283P C3 - 384P C3 - 384P C3 - 386P C3 - 886P C3 - Bike Store C3 - Bike Store C3 - Bike Store C3 - Bike Store C3 - Caulation C3 - Risers	Page 100 200 Essen Tern Ander Are Page 100 200 Essen Tern Ander Are Page 100 100 Essen Tern Ander Are Page 100 100 Essen Tern Ander Are Page 200 100 Essen Tern Ander Are Page 201 100 Essen Tern Ander Are Page 301 100 Essen Tern Ander Page 301 100 Essen Tern Are
B8 - Riser B8 - STORACE EAST B8 - STORACE WEST B8 - STORACE WEST B8 - Verical Civulation C3 - 052P C3 - 182P C3 - 283P C3 - 384P C3 - Bike Store C3 - Bike Store C3 - Buky Waste Store C3 - Risers	Page 100 2000 Escars Bare Addes Page 100 2000 Escars Bare Addes Page 100 2000 Escars Bare Addes Page 100 100 Escars Paramag Page 100 100 Escars Page 100 Esca
B8 - Riser B8 - STORAGE KAST B8 - STORAGE WEST B8 - Verical Civalianon C3 - 682P C3 - 182P C3 - 283P C3 - 384P C3 - 384P C3 - 386P C3 - 886P C3 - Bike Store C3 - Bike Store C3 - Bike Store C3 - Bike Store C3 - Caulation C3 - Risers	Pipe 100 200 Stans Barn Addes Pipe 100 200 Stans Barn Addes Pipe 100 201 Stans Barn Addes Pi
B8 - Riser B8 - STORACE EAST B8 - STORACE WEST B8 - STORACE WEST B8 - Verical Civulation C3 - 052P C3 - 182P C3 - 283P C3 - 384P C3 - 384P C3 - 384P C3 - 384P C3 - 386P C3 - Bike Store C3 - Bike Store C3 - Buky Waste Store C3 - Risers	Page 100 2000 Escale files Added Page 100 2000 Escale files Added Page 100 and Escale Paramag Page 100 and Escale Paramag Page 100 and Escale Paramag Page 100 and Page Page Page Page Page Page Page Page
B8 - Riser B8 - STORAGE KAST B8 - STORAGE WEST B8 - STORAGE WEST B8 - Vertical Civalianon C3 - 052P C3 - 1122P C3 - 283P C3 - 3084P C3 - Bike Store C3 - Risers	Page 100 2000 State Bar Allow Apple Pic 2000 For Parring APP Pic 2000 For Parring APP Pic 2000 For Parring APP Pic 2000 Boars for Marco APP Pic 2000 Boars for Marco APP Pic 2000 Boars for Marco APP R000 A APP R000 AP APP R000 AP APP R000 AP APP R000 APP APP Scale Bar Sone APP Scale Bar Sone APP Scale Bar Sone APP Scale Bar Sone APP Scale Al APP APP APP APP APP Scale Al Date APP <

24 ~~~~



STUDIO EGRET WEST



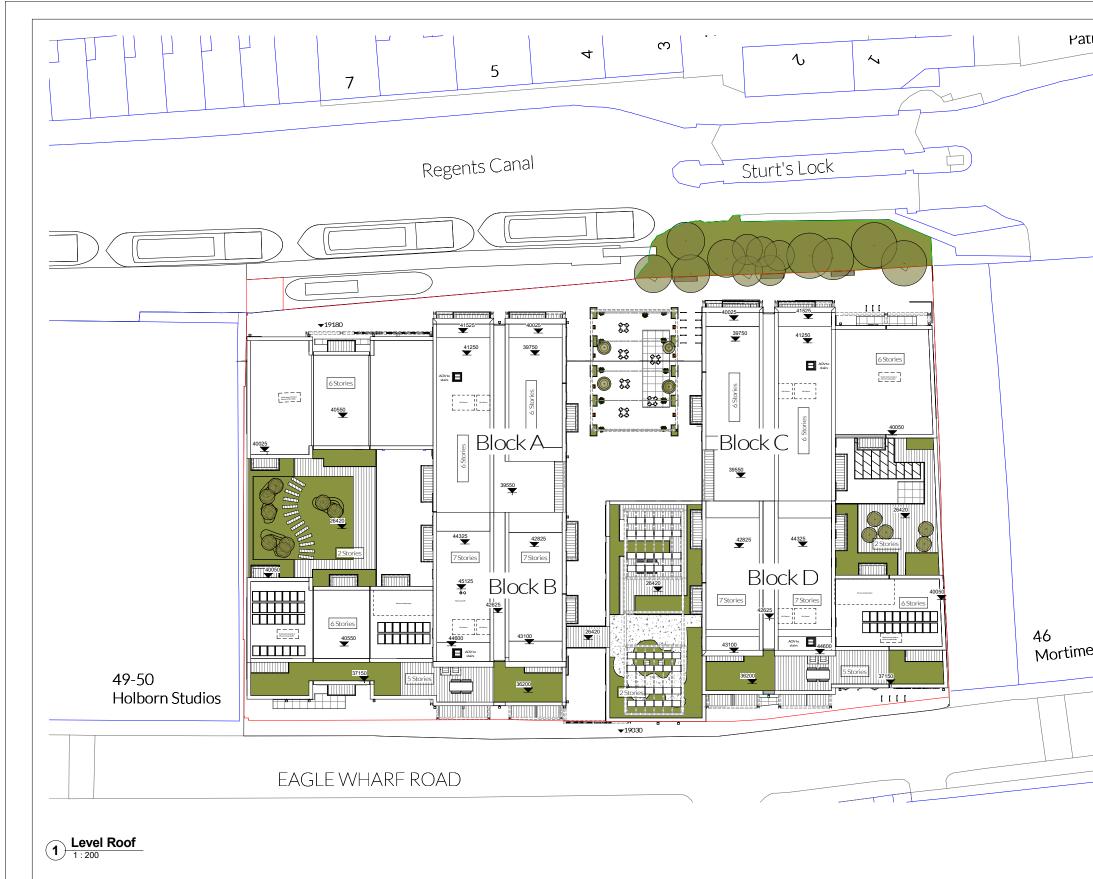

ודה	General Notes Noispile taxes exists. The drang shall not be used to catalide areas for the papers of valuation. One of all table the standy of Advenues to the impounding. All socional carety without the third Stateshin and States (Bauton Martiness). The advenues of the stateshin and states (Bauton martiness).
	Notes Planning Application Boundary
	Boundary Area of tree/planting to be removed and replaced in separate agreement
	Amar Nata San Carlo San
ler Wheeler	P6 30.85.21 Comptend failcoard AP 10 10.000,000 10.000,000 10.000,000 10 10.000,000,000,000,000,000,000,000,000,0
	Scale Bar 0 git 200
EAGLE	Client Access Storage
	Project 0276 Sturt's Yard Drawrg Tife Proposed Access Site - GA Plan - Roof Level
	Project Namber Project Namber For Information Scale at A1 As Indicated 02/03/17 Drawn by RLINO Drawn by RUNO Prevision Pr
	0276-SEW-PA-10-DR-A-001110 P6

STUDIO EGRET WEST

